
## CORNER RECORD

City of Beasore County of Madera , Cal Brief Legal Description Lots 5 & 6 and that portion of Lots 7 & 8 lying easterly of the creek in B of Beasore Meadows Subdivision No. 1, as Recorded in Bk 05 of Maps at Pg 21, MCR  CORNER TYPE COORDINATES (Optional Section 32 Government Corner Control Con	
Section 32 T5S, R23E,  Meander  Rancho  Rancho  No. 1, as Recorded in Bk 05 of Maps at Pg 21, MCR  CORNER TYPE  COORDINATES (Optional Section 1)  E	
Section 32 T5S, R23E, Meander Property Zone NAD83 Epoch	ai) 
Section 32	
T5S, R23E, Meander Property Zone NAD27 NAD	
MDM Rancho D Other NAD83 Epoch	
MDM Rancho	83
	<del></del>
Date of Survey 07/10/08 Vert Datum: NGVD29  NADV88	
· · · · · · · · · · · · · · · · · · ·	erial 🗆
Corner - Left as found  Found and tagged  Established  Reestablished  Rebuil	t 🗆
	<del></del>
Identification and type of corner found: Evidence used to identify or procedure used to establish or reestablish the corner:	Ď
Found and accepted 5/8" iron pipes with no tags, or monuments as noted.	<del></del>
Established missing corner monument using the monuments found and bearings and distances	<u>as</u>
shown on the record map. (See sketch, page 2)	
A description of the physical condition of the monument as found and as set or reset:	
AMP	
Set 3/4" x 30" iron pipe tagged LS4633 up 2" See sketch, Page 2)	
State Day Por	
ROBIN D.	A
	1
SURVEYOR'S STATEMENT RASMUSSEN	i E
This Corner Record was prepared by me or under my direction in conformance with	
This Corner Record was prepared by me or under my direction in conformance with	
This Corner Record was prepared by me or under my direction in conformance with	
This Corner Record was prepared by me or under my direction in conformance with	
This Corner Record was prepared by me or under my direction in conformance with the Land Surveyor's Act on January 12 , 2012  Signed PLS No: 4633  COUNTY SURVEYOR'S STATEMENT	
This Corner Record was prepared by me or under my direction in conformance with the Land Surveyor's Act on January 12 , 2012  Signed PLS No: 4633  COUNTY SURVEYOR'S STATEMENT	NO S
This Corner Record was prepared by me or under my direction in conformance with the Land Surveyor's Act on January 12  PLS No: 4633  COUNTY SURVEYOR'S STATEMENT	NO SUR
This Corner Record was prepared by me or under my direction in conformance with the Land Surveyor's Act on January 12  PLS No: 4633  COUNTY SURVEYOR'S STATEMENT  This Corner Record was received 2/0 2012 and examined and filed 2/27 2012  DAVID	NO SUBJECT
This Corner Record was prepared by me or under my direction in conformance with the Land Surveyor's Act on	
This Corner Record was prepared by me or under my direction in conformance with the Land Surveyor's Act on	SON S
This Corner Record was prepared by me or under my direction in conformance with the Land Surveyor's Act on	SON S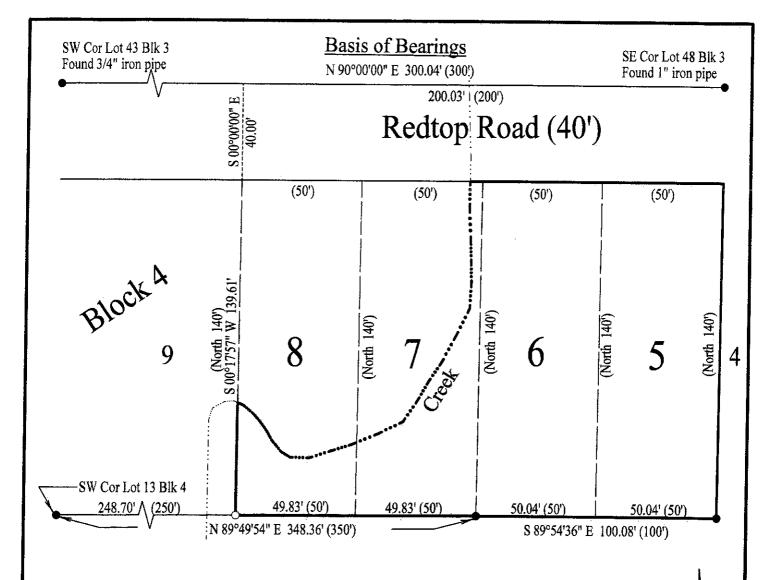
## Legend

- Found and accepted 5/8" iron pipe, or monument as noted
- (...) Record data per plat of Beasore Meadows Subdivision No. 1, Bk 5 of Maps, Pg 21, MCR
- O Set 3/4" x 30" iron pipe tagged LS4633 up 2"

## Basis of Bearings

Bearings are based on the north line of Redtop Road as shown on plat of Beasore Meadows Subdivision No. 1, Bk 5 of Maps, Pg 21, MCR, which bears N 90°00'00" E

## CORNER RECORD

Of Lots 5 and 6 and that portion of Lots 7 and 8 lying easterly of the creek in Block 4 of Beasore Meadows Subdivision No. 1 Book 5 of Maps, at Page 21, MCR, Madera County, California

Page 2 of 2

Scale: 1"=40'

January 12, 2012