

Form 3252-7-47-2M

SAN JOAQUIN POWER DIVISION  
SECTION CORNER TIE TAG

Ties by G.W. Gillet T. 11 S., R. 16 E., M.D.B. & M., Section 30

Date 7-15-48

Monument Set by

Date

DESCRIPTION OF MONUMENT  
3" x 3" 12" below


SWING TIES

- 21.71' S of tel. line E-W
- 36.49' SW of @ on cor. fence post
- 170' SW of @ on tel. pole
- 27.8' W of power line North
- 224.48' NW of @ on power pole
- 28.2' N of power line E-W
- 39.55' NE of @ on power pole
- 28' E of power line South
- 37.73' SE of @ on tel. pole
- 36.65' SE of @ on cor. fence post

NW Corner  
(Use NW, W. 1/4, N. 1/4, Cen. 1/4 when possible)

Field Book No. Pages

Field Book Filed

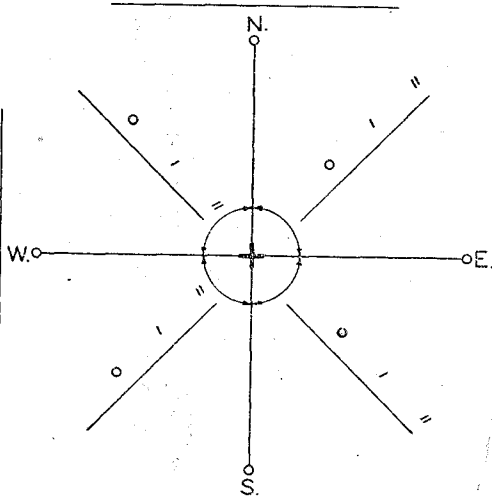

John C. Moore Corporation, Rochester, N. Y. Binder and holes in leaves Patented

Form 180

Form 3252-7-47-2M

SAN JOAQUIN POWER DIVISION  
SECTION CORNER TIE TAG

Ties by G.W. Gillet T. 11 S., R. 16 E., M.D.B. & M., Section 19

Date 7-15-48

Monument Set by

Date

DESCRIPTION OF MONUMENT  
Conc. mon. 12" below


SWING TIES

- 38.04' SW of @ on fence post North
- 28' E of power line N-S
- 22.11' NW of @ in North gate post
- 66.71' NW of @ in power pole
- 39.91' NW of @ in power pole
- 33.40' NW of @ in cor. fence post
- 28' N of power line E-W
- 79.10' NE of @ in switch pole #270

NW Corner  
(Use NW, W. 1/4, N. 1/4, Cen. 1/4 when possible)

Field Book No. Pages

Field Book Filed

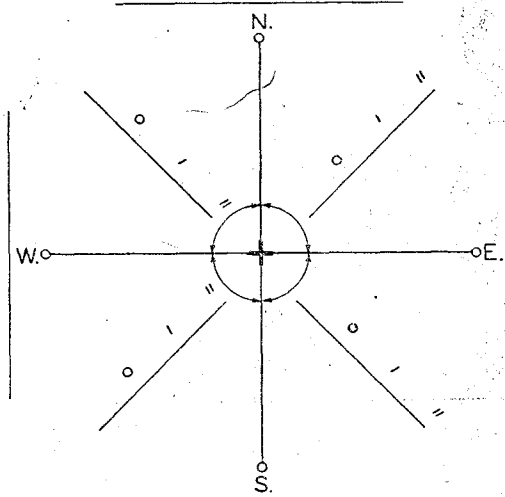

John C. Moore Corporation, Rochester, N. Y. Binder and holes in leaves Patented

Form 180