

# Madera County Environmental Health As-Built

FAILURE TO PROVIDE ALL REQUIRED INFORMATION SHALL PREVENT INSTALLER FROM OBTAINING ENVIRONMENTAL HEALTH DEPARTMENT'S APPROVAL SEWAGE SYSTEM TAG.

Job Address: \_\_\_\_\_ APN: \_\_\_\_--\_\_\_\_--\_\_\_\_

System Information: New \_\_\_\_\_ Repair \_\_\_\_\_

Tank Size: \_\_\_\_\_ Gallon

Number of Leach Line: \_\_\_\_\_ Total Length: \_\_\_\_\_ Ft Width: \_\_\_\_\_ Ft Depth: \_\_\_\_\_ Ft Tons: \_\_\_\_\_

Number of Chamber System Line: \_\_\_\_\_ Total Number of Units Installed: \_\_\_\_\_ Length of Unit: \_\_\_\_\_

Number of Seepage Pit: \_\_\_\_\_ Diameter: \_\_\_\_\_ Depth: \_\_\_\_\_ Rock Fill: \_\_\_\_ Brick Line: \_\_\_\_  
(Sketch of system must include distance from street, wells, property lines, trees, foundation of house, and so on)

Installer's Name: \_\_\_\_\_ Signature: \_\_\_\_\_ Date: \_\_\_\_\_

# MADERA COUNTY ENVIRONMENTAL HEALTH MANDATORY SEWAGE SYSTEM AS-BUILT DRAWING

(Final Permit Approval May Be Withheld If Not Submitted At The Time Of Inspection)

JOB ADDRESS:           **12345 HIGHWAY 41**

CITY:   **OAKHURST**

OWNER (S):           **JOE PUBLIC**

APN #: **XXX-XXX-XXX**

INSTALLER:           **AAA SEPTIC**

DATE: **January 10, 2003**

SYSTEM INFORMATION:    NEW    REPAIR

TANK SIZE: **1500** GALLONS   MANUFACTURER: **AAA SEPTIC**


LEACH LINE(S): #: **2** LENGTH: **100 TOTAL** (FEET), WIDTH: **24** (INCHES), DEPTH: **4** (FEET), TONS: **50**

CHAMBER SYSTEM: NUMBER OF LINES: \_\_\_\_\_ NUMBER OF UNITS PER LINE: \_\_\_\_\_

CHAMBER SYSTEM: MANUFACTURER: \_\_\_\_\_ NUMBER OF LINES: \_\_\_\_\_

SEEPAGE PITS(S): #: \_\_\_\_\_, DIAMETER: \_\_\_\_\_ (FEET), DEPTH: \_\_\_\_\_ (FEET), MATERIAL: \_\_\_\_\_

CORNERS OF BUILDINGS ARE THE TWO (A) (B) REFERENCE POINTS (IF NOT AVAILABLE, USE OTHER PERMANENT MARKERS: PROPERTY STAKES, TREES, BOULDERS, ETC.). SKETCH OF SYSTEM MUST INCLUDE DISTANCE FROM: STREETS, WELLS, DRAWS, CREEKS, PROPERTY LINES.

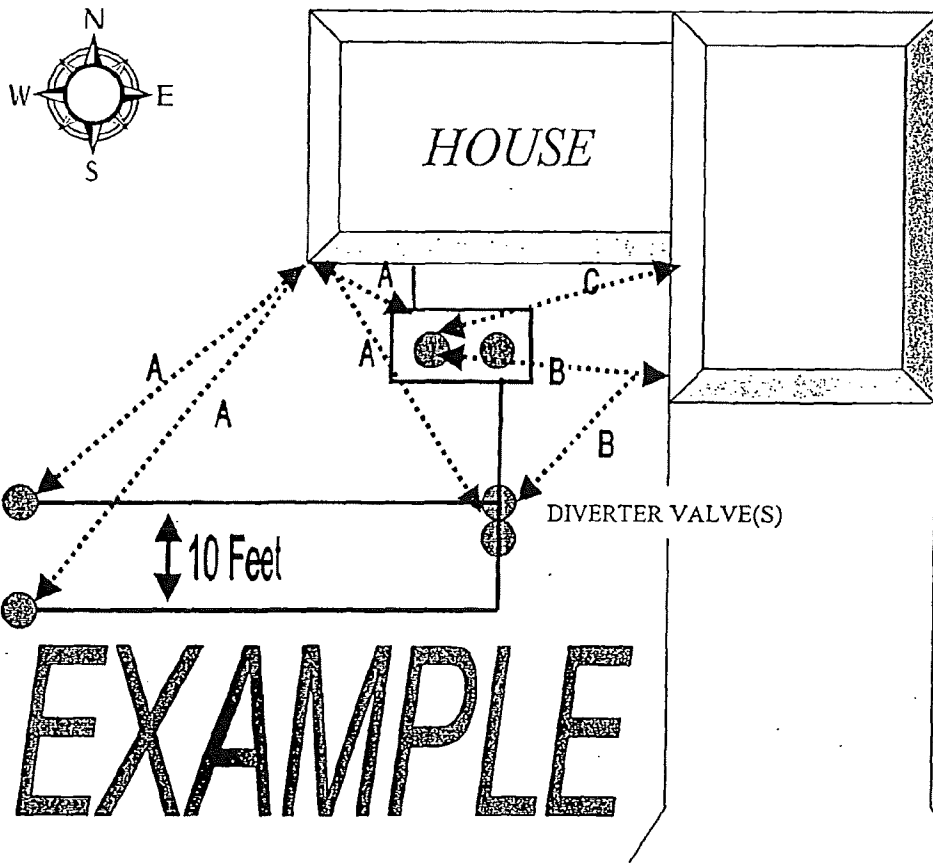

DISTANCE FROM:	TO:	MANHOLE - FIRST COMPARTMENT	VALVE(S)	INSPECTION PORTS
A.	SW CORNER OF HOUSE	12 FEET	30 FEET	40/50 FEET
B.	SW CORNER OF GARAGE	20 FEET	18 FEET	70/80 FEET
C.	INTERIOR CORNER HOUSE	20 FEET	30 FEET	80/90 FEET
D.	WELL	100+ FEET		
E.				